


NOTES  
 1. ALL DIMENSIONS IN MILLIMETRES AND ALL LEVELS IN METRES UNLESS SHOWN OTHERWISE.

REFERENCES  
 APPLICATION AREA

REFERENCES  
 JN.497392.0Z0712 NEW INTERMEDIATE PUMPING STATION  
 LANDSCAPE PLAN  
 JN.497392.0Z0713 INTERMEDIATE PUMPING STATION  
 KIOSK, PLINTH  
 PLAN AND SECTION

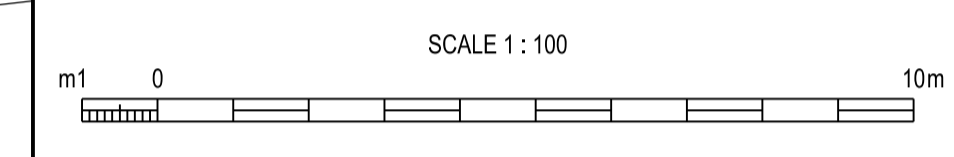

CURRENT VERSION INFORMATION

DATE	DRWN	CHKD	REVD	REV	REASON FOR ISSUE
30.05.2019	DWH	JAS	SG	A	AS BUILT

THIS DRAWING IS ISSUED BY SOUTHERN WATER SUBJECT TO THE CONDITIONS THAT IT IS NOT COPIED EITHER IN WHOLE OR IN PART OR DISCLOSED TO THIRD PARTIES UNLESS PRIOR WRITTEN AUTHORISATION IS GIVEN BY SOUTHERN WATER. PREVIOUS VERSIONS OF THIS DRAWING SHOULD BE STAMPED SUPERSEDED OR DESTROYED. DO NOT SCALE THIS DRAWING - IF IN DOUBT ASK.



*In Partnership with*



Southern House  
 Yeoman Road  
 Worthing  
 West Sussex  
 BN13 3NX  
 telephone (01903) 264444  
 fax (01903) 691435

PROJECT TITLE  
 MOUNTFIELD - FIRST TIME SEWERAGE SCHEME

DRAWING TITLE  
 PLANNING APPLICATION  
 PUMPING STATION  
 GENERAL SITE LAYOUT

SITE UNIT MNEMONIC	SITE UNIT NO.
PRN 497392	SCALE 1:100
S.W. DRAWING NO. JN.497392.0Z0711	MASTER SIZE A1
	REVISION A