

S.W. DRAWING NO. JN.497392.0Z0712 REVISION A

LEGEND

- NEW FOUL WATER PUMPED MAIN
- NEW FOUL WATER GRAVITY MAIN
- NEW STANDARD KERB
- NEW DROP KERB
- EXISTING TIMBER FENCE
- PROPOSED 1.2M HIGH TIMBER POST AND 3 RAIL FENCE
- NEW 1.8M HIGH GREEN WELDMESH SECURITY FENCE
- SITE COMPOUND
- NEW ASPHALT HARD STANDING
- NEW GRASS (HAYMEADOW MIX) - E.G. GERMINAL RE1 (MG5 GRASSLAND)
- EXISTING HEDGEROW TO BE RETAINED
- NEW HEDGEROW
- NEW CONCRETE HARD STANDING (AS PER ENGINEERS SPECIFICATION)
- NEW PERMEABLE HARD STANDING (AS PER ENGINEERS SPECIFICATION)
- NEW TYPE 1 (AS PER ENGINEERS SPECIFICATION)
- EXISTING GROUND LEVEL
- FINISHED GROUND LEVEL
- MH/IC MANHOLE / INSPECTION CHAMBER
- NEW BT POLE
- DEMARCATON CHAMBER

REFERENCES

- JN.497392.0Z0711 PLANNING APPLICATION
- JN.497392.0Z0713 PUMPING STATION SITE LAYOUT INTERMEDIATE PUMPING STATION KIOSK PLINTH PLAN AND SECTION

SCALE 1 : 100


NOTES

- THIS DRAWING IS NOT TO BE SCALED.
- ALL DIMENSIONS ARE IN MILLIMETRES & ALL LEVELS IN METRES ABOVE ORDANANCE DATUM (mAOD) UNLESS SHOWN OTHERWISE.
- ALL WORKS COMPLY WITH SOUTHERN WATER SPECIFICATION, CESWI 7th EDITION AND SFA 7th EDITION.
- THE LOCATION OF EXISTING PIPEWORK AND OTHER UTILITY SERVICES ROUTES BASED ON UTILITY COMPANY RECORDS, SUPPLEMENTED WHERE POSSIBLE BY ONSITE SERVICE TRACING AND ARE APPROXIMATE ONLY.
- REFER TO SPECIFICATION FOR GENERAL CONSTRUCTION.
- ALL EXISTING SURFACE WHERE DISTURBED REINSTATED TO THE SATISFACTION OF THE ENGINEER.
- FOR PUMPING STATION DETAILS REFER TO DRAWING 5105602-WA-116 AND PROPOSED LAYBY CROSS SECTION REFER TO DRAWING 5105602-WA-119.
- FOR LONG SECTION REFER TO DRAWING 5105602-WA-122, 126, AND 128.

SAFETY, HEALTH AND ENVIRONMENTAL INFORMATION

- IN ADDITION TO THE HAZARDS/RISKS NORMALLY ASSOCIATED WITH THE TYPES OF WORK DETAILED ON THIS DRAWING, NOTE THE FOLLOWING SIGNIFICANT RESIDUAL RISKS
- CONSTRUCTION**
- STRIKING LIVE SERVICES (LOW PRESSURE GAS PIPELINE AND LV ELECTRICITY IN THE VICINITY OF WORKS). UTILITY SERVICE ROUTES BASED ON UTILITY COMPANY RECORDS, SUPPLEMENTED WHERE POSSIBLE BY ONSITE SERVICE TRACING. THERE ARE KNOWN SERVICES IN THE VICINITY OF PROPOSED SEWER WHICH ARE REQUIRED TO BE PROTECTED / DIVERTED DURING CONSTRUCTION. CONTRACTOR TO CONFIRM ALL SERVICES PRIOR TO COMMENCING OF WORK AND ADVISE THE ENGINEER OF ANY PERCEIVED CONFLICT WITH THE PROPOSED WORKS.
 - COLLISION WITH TRAFFIC DURING SITE ACCESS AND WORKING NEAR ACCESS ROAD. TRAFFIC MANAGEMENT TO BE IN PLACE.
- MAINTENANCE/ CLEANING**
- COLLISION WITH TRAFFIC DURING SITE ACCESS AND WORKING NEAR ACCESS ROAD. TRAFFIC MANAGEMENT TO BE IN PLACE.
 - CONFINED SPACE-DEEP MANHOLES. METHOD STATEMENT TO BE AGREED BEFORE UNDERTAKING ANY MAINTENANCE WORKS IN DEEP MANHOLES.
- DECOMMISSIONING/DEMOLITION**
- COLLISION WITH TRAFFIC DURING SITE ACCESS AND WORKING NEAR ACCESS ROAD. TRAFFIC MANAGEMENT TO BE IN PLACE.

Name	Abbreviations	Overall Size	Root Condition	Container size	Hedge length in meters	% Mix	Density per linear meter	No.
Acer Campestre	A	80-100cm	1 +2 Bare root	N/A	177	5%	5	44
Carpinus betulus	CR	80-100cm	1 +2 Bare root	N/A	177	20%	5	177
Crataegus monogyna	C	80-100cm	1 +1 Bare root	N/A	177	45%	5	398
Ilex aquifolium	I	60-80cm	Container grown	2L	177	10%	5	89
Lonicera Prilymenum	L	100-125cm	Container grown	2L	177	5%	5	44
Sambucus nigra	S	60-80cm	1 u 1 Bare root	N/A	177	5%	5	44
Viburnum lantana	V	80-100cm	1 +1 Bare root	N/A	177	10%	5	89
						100%		

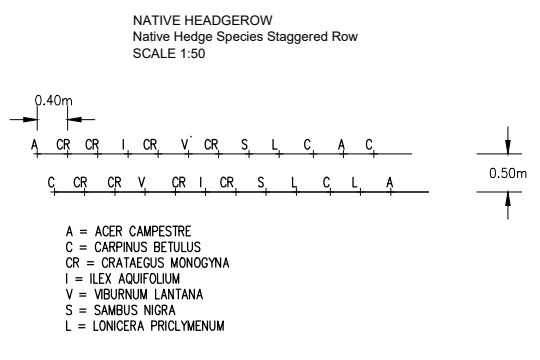

CURRENT VERSION INFORMATION

DATE	DRWN	CHKD	REVD	REV	REASON FOR ISSUE
30.05.2019	DWH	JAS	SG	A	AS BUILT

THIS DRAWING IS ISSUED BY SOUTHERN WATER SUBJECT TO THE CONDITIONS THAT IT IS NOT COPIED EITHER IN WHOLE OR IN PART OR DISCLOSED TO THIRD PARTIES UNLESS PRIOR WRITTEN AUTHORISATION IS GIVEN BY SOUTHERN WATER. PREVIOUS VERSIONS OF THIS DRAWING SHOULD BE STAMPED SUPERSEDED OR DESTROYED. DO NOT SCALE THIS DRAWING - IF IN DOUBT ASK.

Southern House
Yeoman Road
Worthing
West Sussex
BN13 3NX
telephone (01903) 264444
fax (01903) 691435

PROJECT TITLE
MOUNTFIELD - FIRST TIME SEWERAGE SCHEME

DRAWING TITLE
NEW INTERMEDIATE PUMPING STATION LANDSCAPE PLAN

PRN 497392	SCALE 1:100	MASTER SIZE A1
S.W. DRAWING NO. JN.497392.0Z0712	REVISION A	