




SECTION A-A  
SCALE 1:10

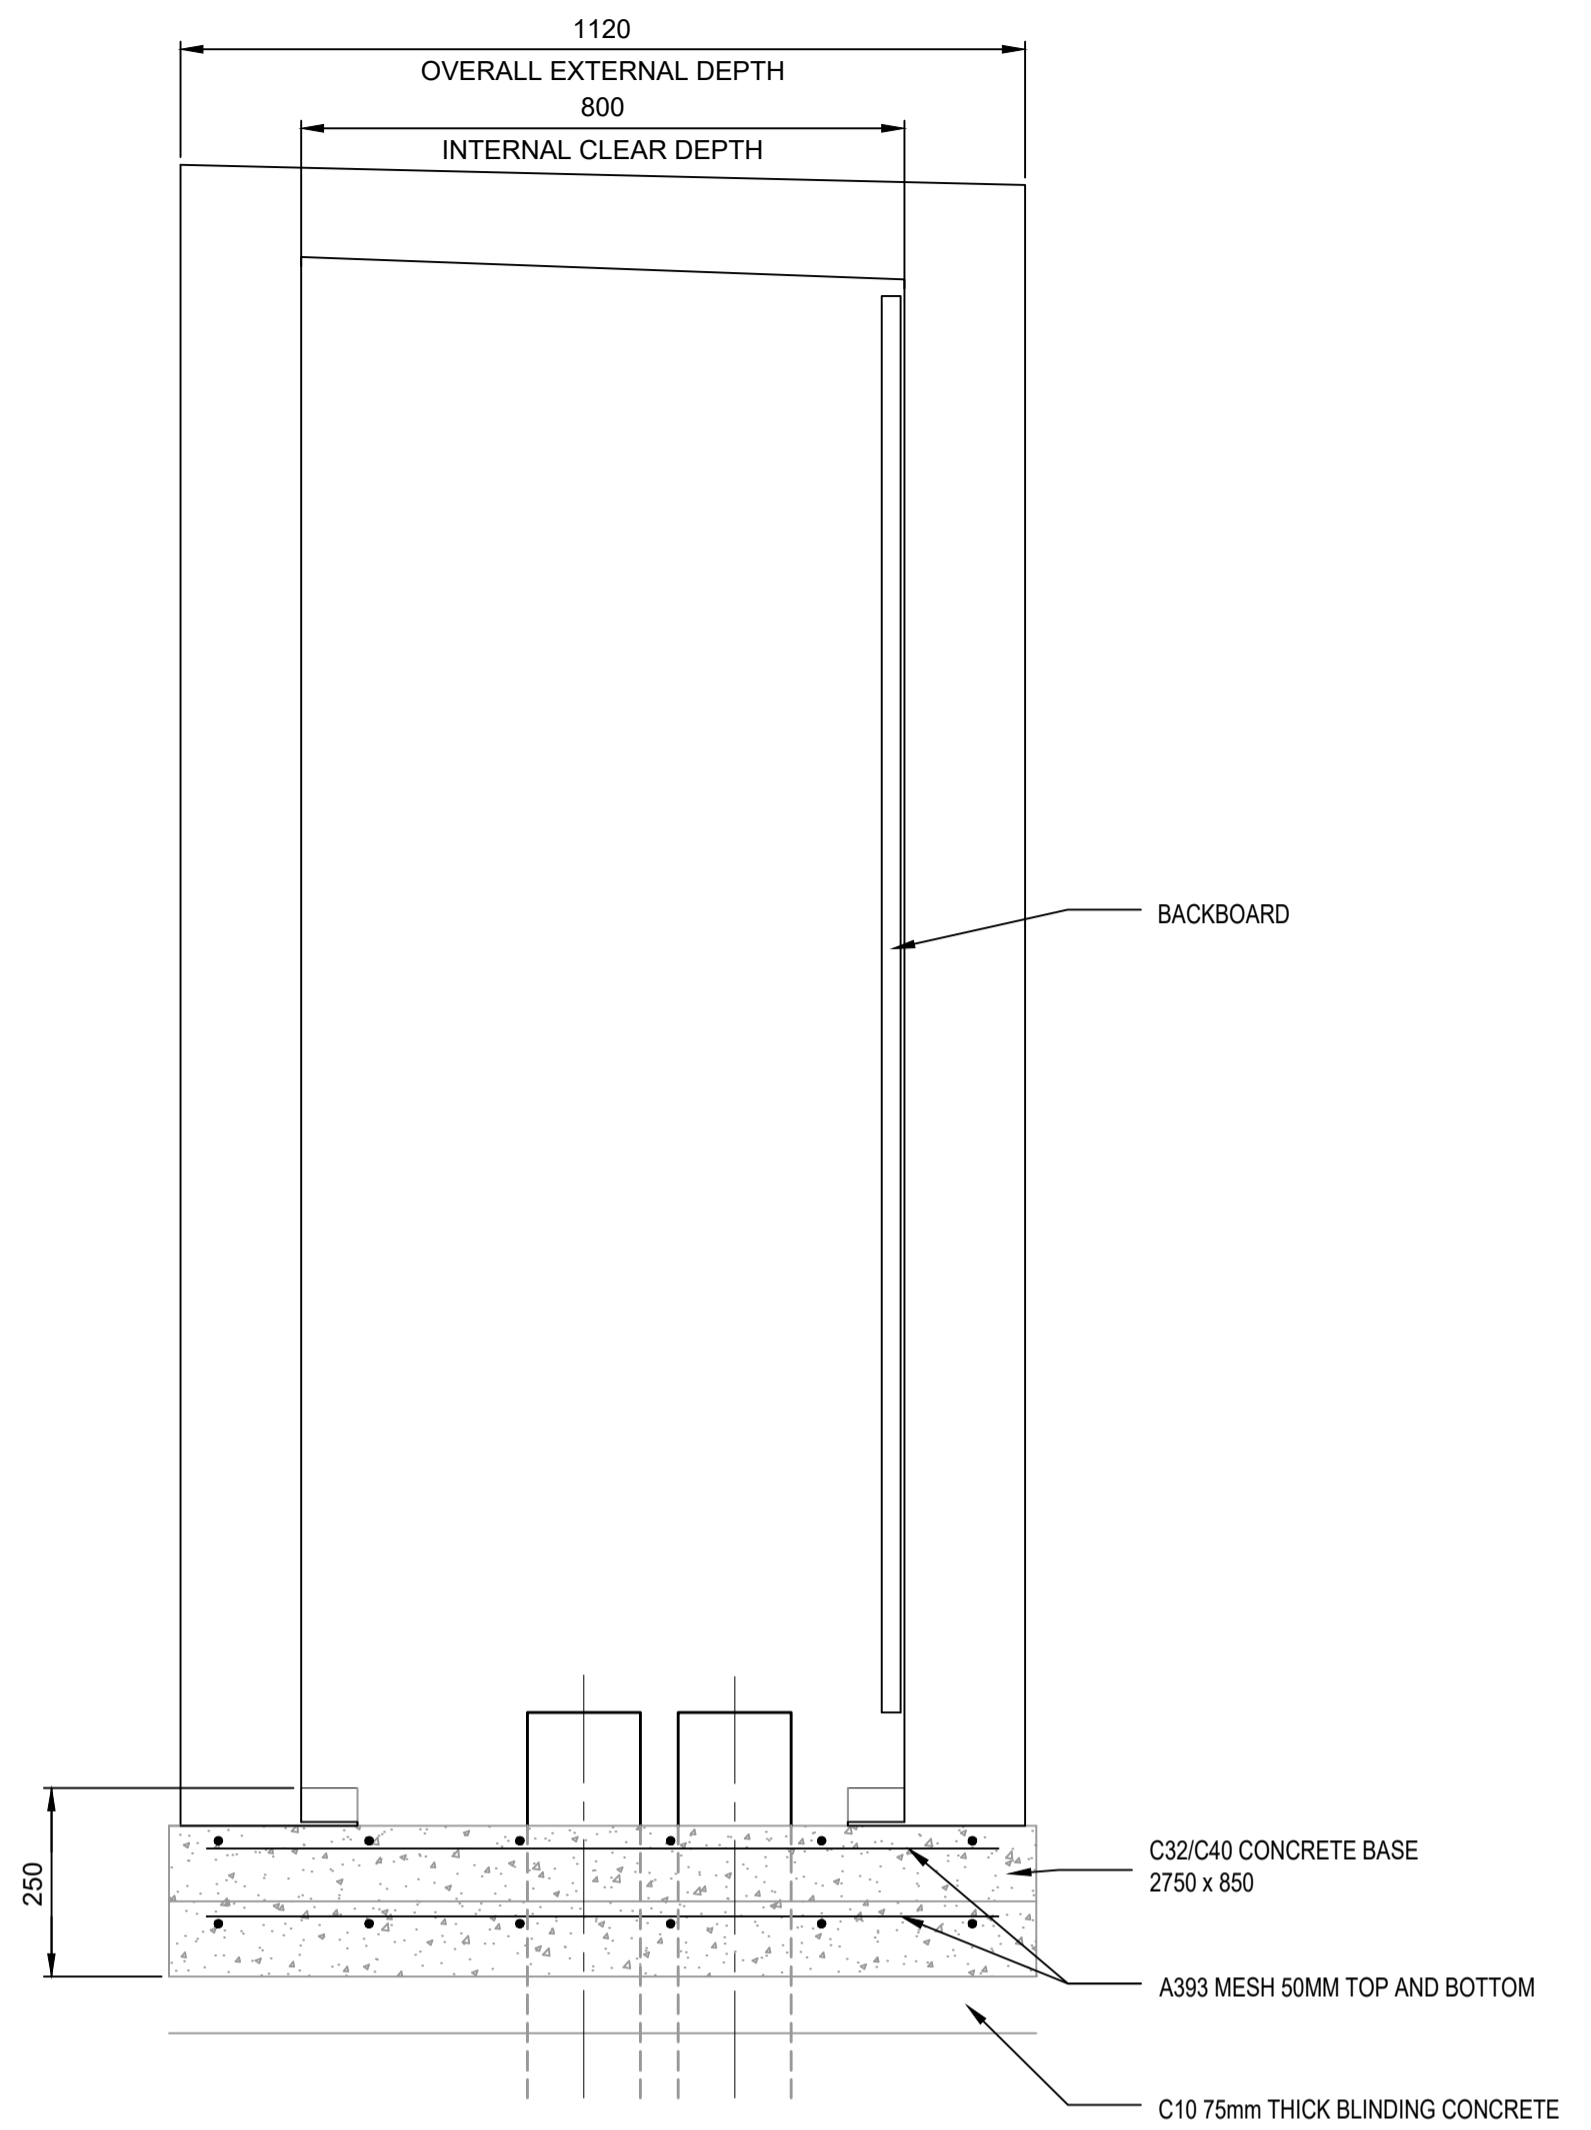

SECTION B-B  
SCALE 1:10

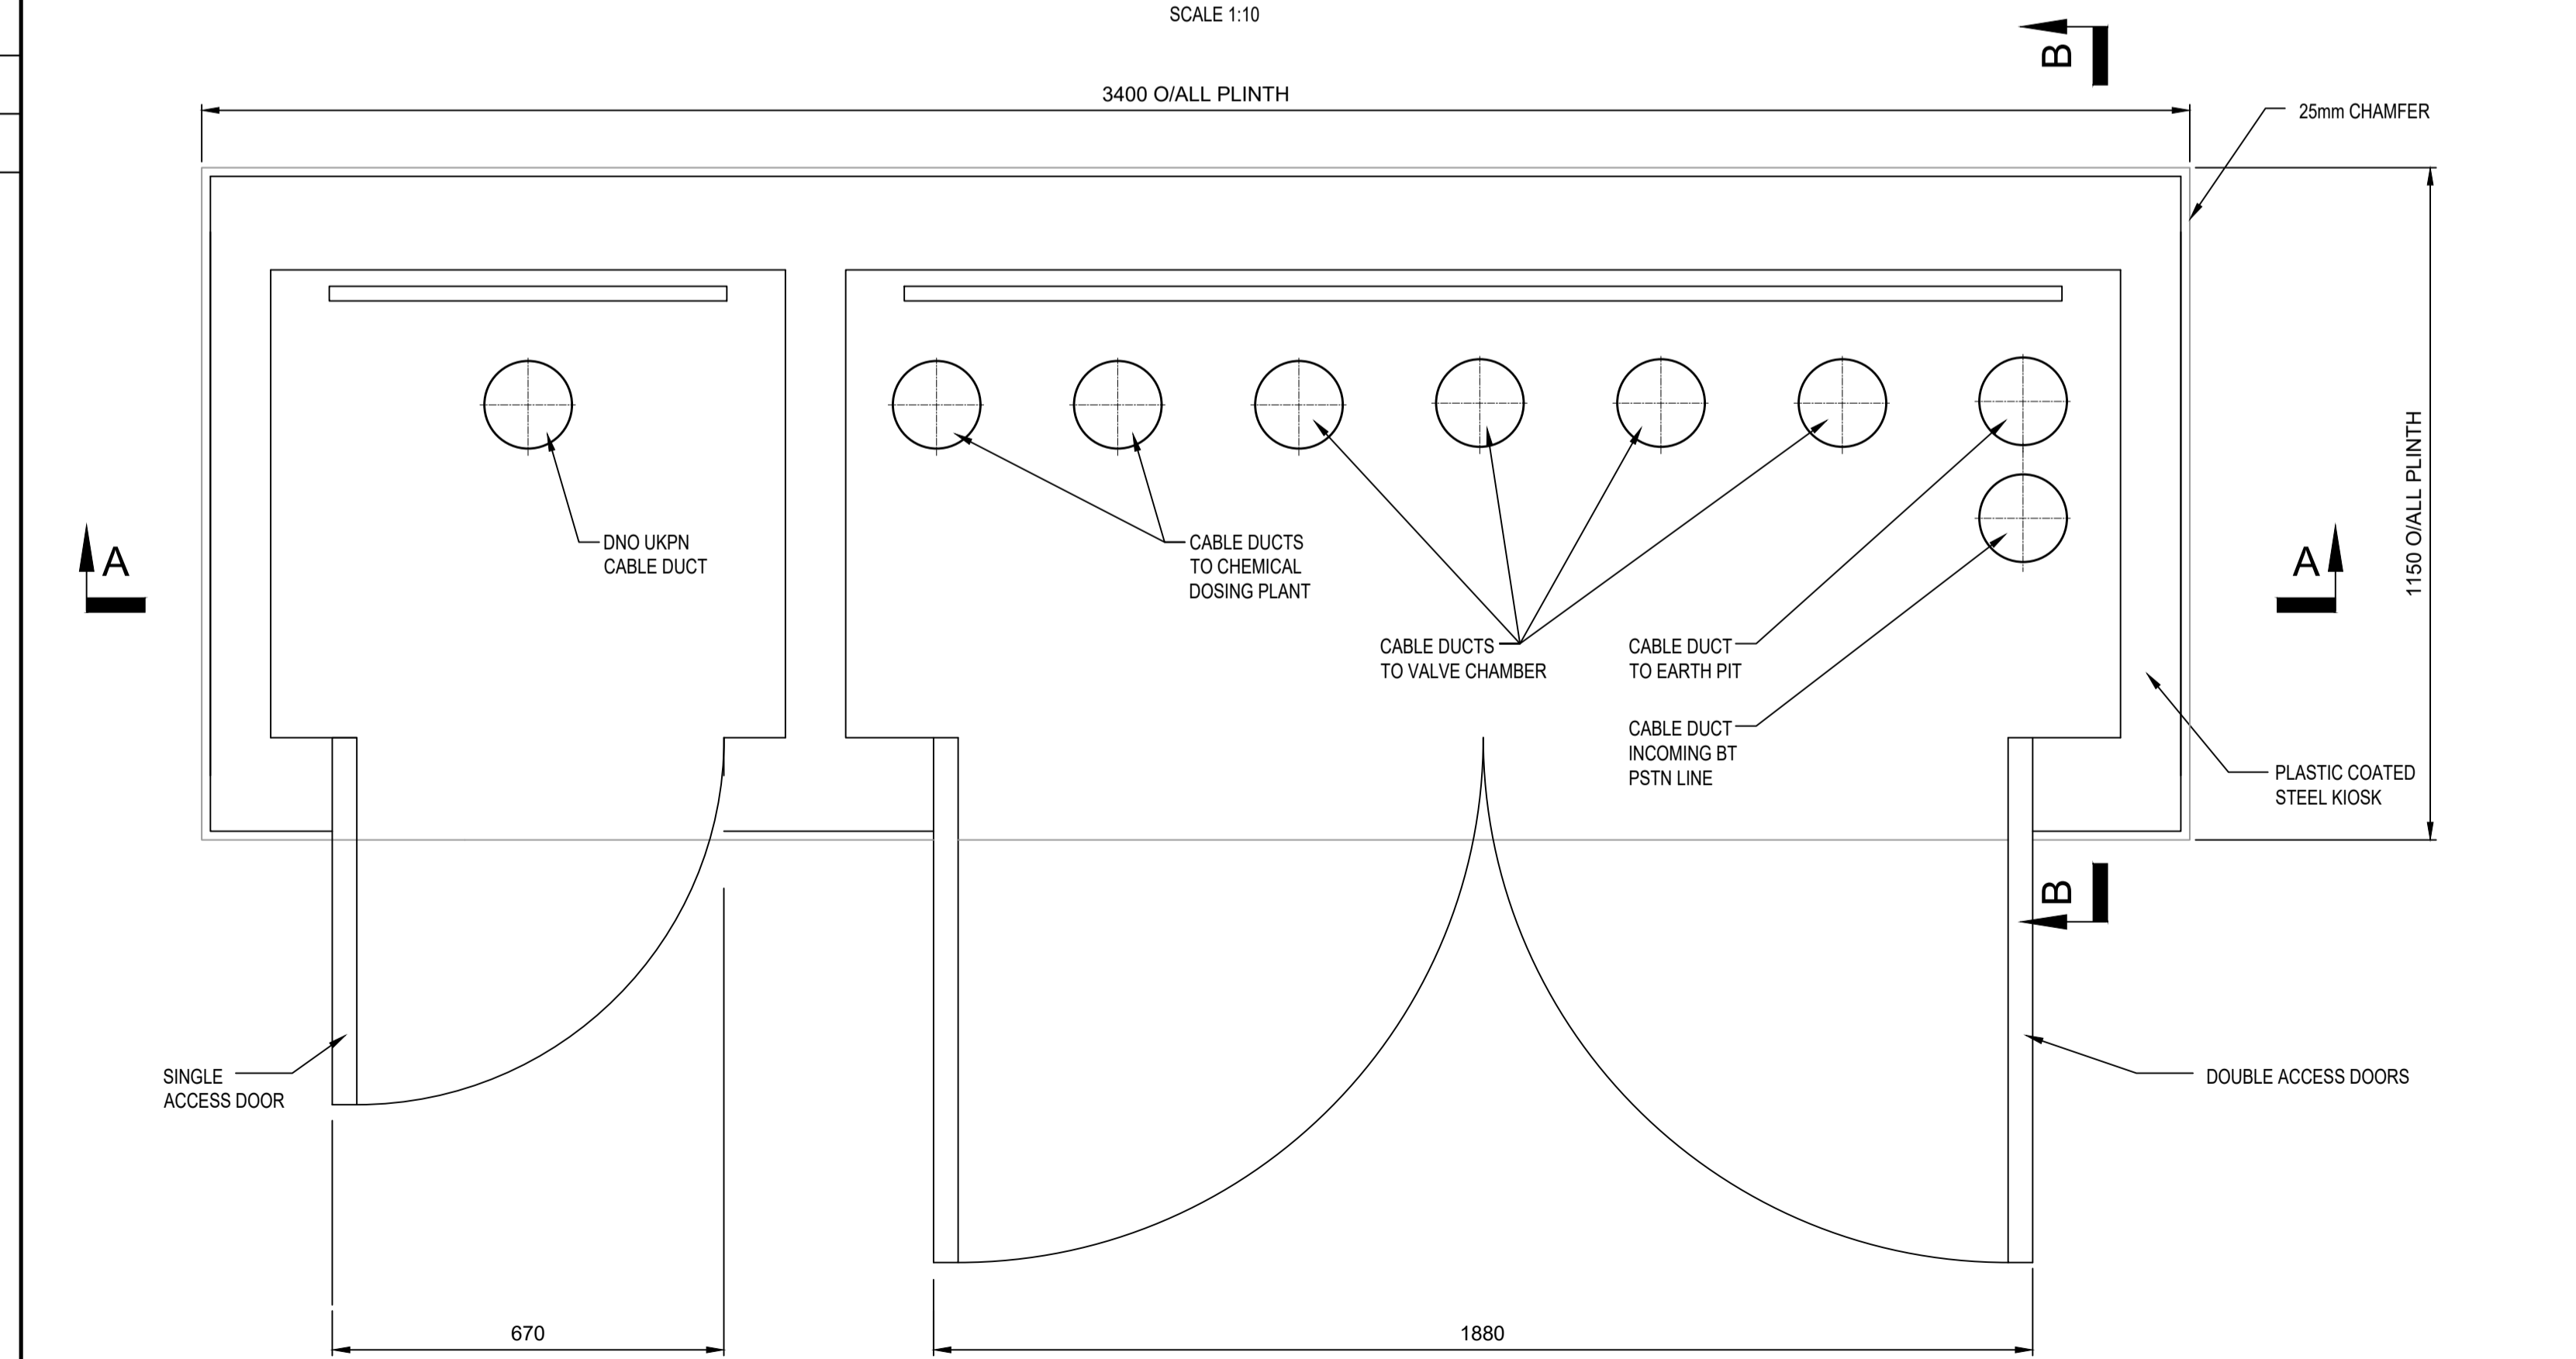


PLAN  
SCALE 1:10

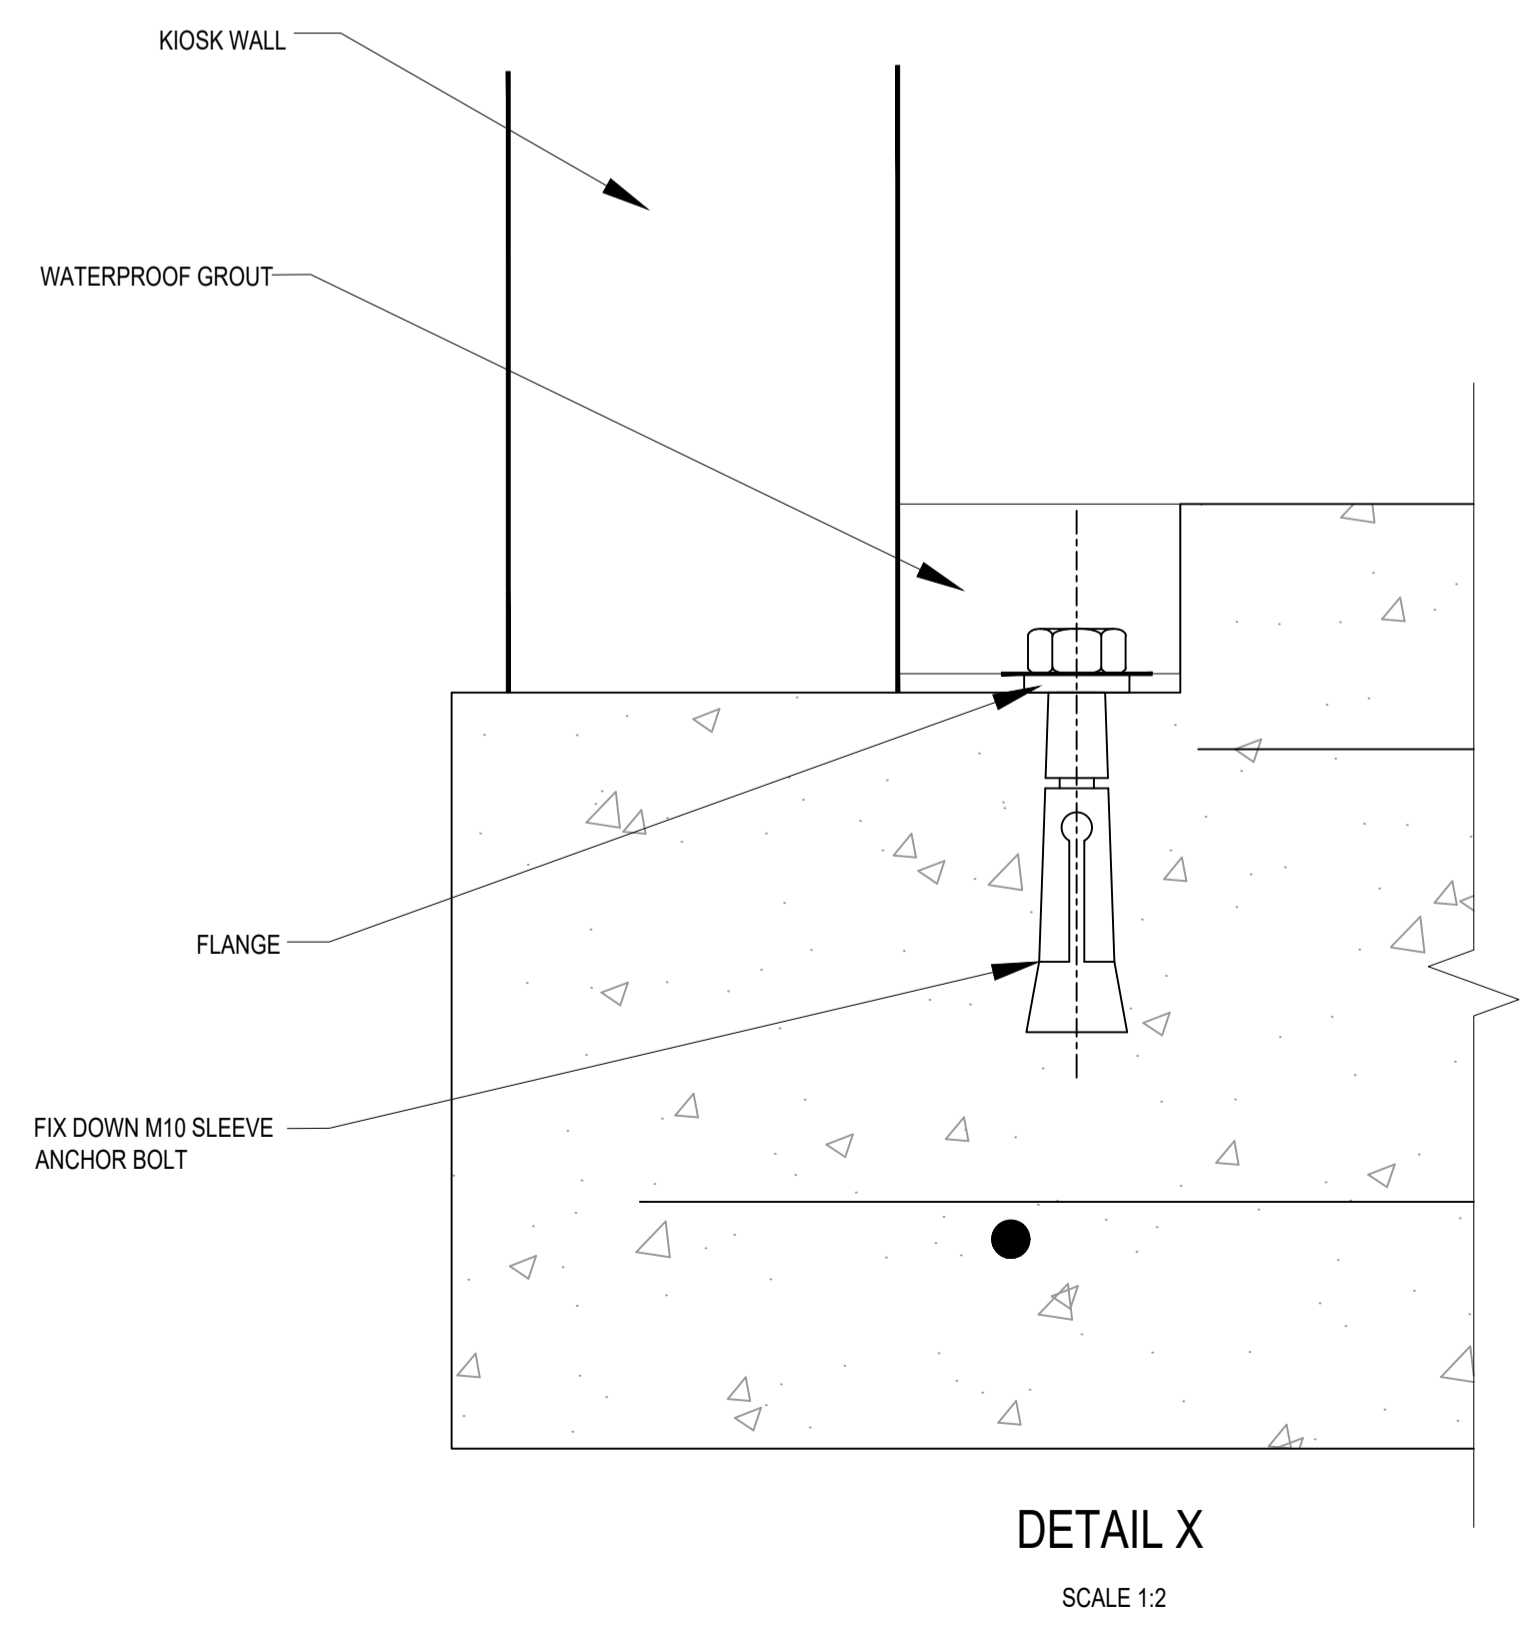

DETAIL X  
SCALE 1:2

- NOTES**
1. ALL DIMENSIONS ARE IN MILLIMETRES UNLESS SHOWN OTHERWISE.
  2. 25 x 25mm CHAMFER FOR ALL EXPOSED EDGES OF CONCRETE PLINTH.
  3. PLASTIC COATED STEEL WATERPROOF CABINET.
  4. SURFACE FINISH AND COLOUR TO BLEND IN WITH EXISTING ENVIRONMENT.
  5. THE METHOD OF SEALING BURIED CABLE DUCTS AND CABLE DUCT ENTRIES INTO THE BUILDING AND KIOSK SHALL WITH THE REQUIREMENTS OF WIMES 3.02.
  6. CABLE DUCTS INSTALLED AND LEFT WITH A DRAW CORD AFTER INSTALLATION.

- REFERENCES**
- JN.497392.0Z0711 PLANNING APPLICATION PUMPING STATION GENERAL SITE LAYOUT
  - JN.497392.0Z0712 NEW INTERMEDIATE PUMPING STATION LANDSCAPE PLAN

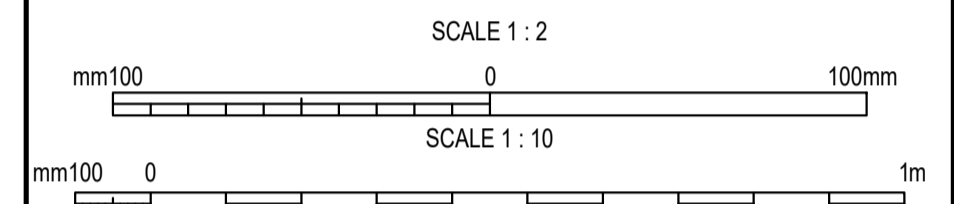

**CURRENT VERSION INFORMATION**

DATE	DRWN	CHKD	REVD	REV	REASON FOR ISSUE
30.05.2019	DWH	JAS	SG	A	AS BUILT

THIS DRAWING IS ISSUED BY SOUTHERN WATER SUBJECT TO THE CONDITIONS THAT IT IS NOT COPIED EITHER IN WHOLE OR IN PART OR DISCLOSED TO THIRD PARTIES UNLESS PRIOR WRITTEN AUTHORISATION IS GIVEN BY SOUTHERN WATER. PREVIOUS VERSIONS OF THIS DRAWING SHOULD BE STAMPED SUPERSEDED OR DESTROYED. DO NOT SCALE THIS DRAWING - IF IN DOUBT ASK.

PROJECT TITLE  
MOUNTFIELD - FIRST TIME SEWERAGE SCHEME

DRAWING TITLE  
INTERMEDIATE PUMPING STATION  
KIOSK AND PLINTH  
PLAN AND SECTION

SITE UNIT MNEMONIC	SITE UNIT NO.
--------------------	---------------

PRN 497392	SCALE AS SHOWN	MASTER SIZE A1
------------	----------------	----------------