


- NOTES**
1. ALL DIMENSIONS IN MILLIMETRES AND ALL LEVELS IN METRES UNLESS SHOWN OTHERWISE.
  2. ALL WORKS COMPLY WITH SOUTHERN WATER SPECIFICATION CESWI 7th EDITION AND SFA 7th EDITION.
  3. THE LOCATION OF EXISTING PIPEWORK AND OTHER UTILITY SERVICES ROUTES ARE APPROXIMATE ONLY AND ARE BASED ON UTILITY COMPANY RECORDS AND ALSO WHERE POSSIBLE BY ONSITE SERVICE TRACING.
  4. REFER TO SPECIFICATION FOR GENERAL CONSTRUCTION.
  5. ANY EXISTING DISTURBED SURFACE WAS REINSTATED TO THE SATISFACTION OF THE ENGINEER.
  6. CONTRACTION AND EXPANSION JOINTS SPACED AT 6m
  7. LAND AROUND PS COMPOUND WAS FILLED AND GRADED BACK TO EXISTING GROUND LEVEL AT 1 IN 10 SLOPE. SLOPE WAS LOCALLY STEEPENED TO MATCH EXISTING GROUND LEVEL ON PROPERTY AND FARM ACCESS BOUNDARIES.
  8. 600mm ROCKER PIPES PROVIDED AT EVERY MANHOLE ENTRY AND EXIT AS PER CLAUSE 5.19 CESWI 7th. PIPE CONNECTION INTO MANHOLES IS WATER TIGHT.
  9. DUCTS WERE INSTALLED WITH 300mm CENTERS. BEDDING DETAILS AND MINIMUM COVER AS PER SW DRAWING A81945.1704.

- REFERENCES**
- JN.497392.1C2902 SECTION VIEWS OF INTERMEDIATE PUMPING STATION SHEET 2 OF 3  
 JN.497392.1C2903 SECTION VIEWS OF INTERMEDIATE PS SHEET 3 OF 3  
 JN.497392.1C2904 DITCH CROSSING GENERAL ARRANGEMENT AND DETAILS  
 JN.497392.1C2905 INTERMEDIATE PUMPING STATION KIOSK PLINTH, PLAN AND SECTION.

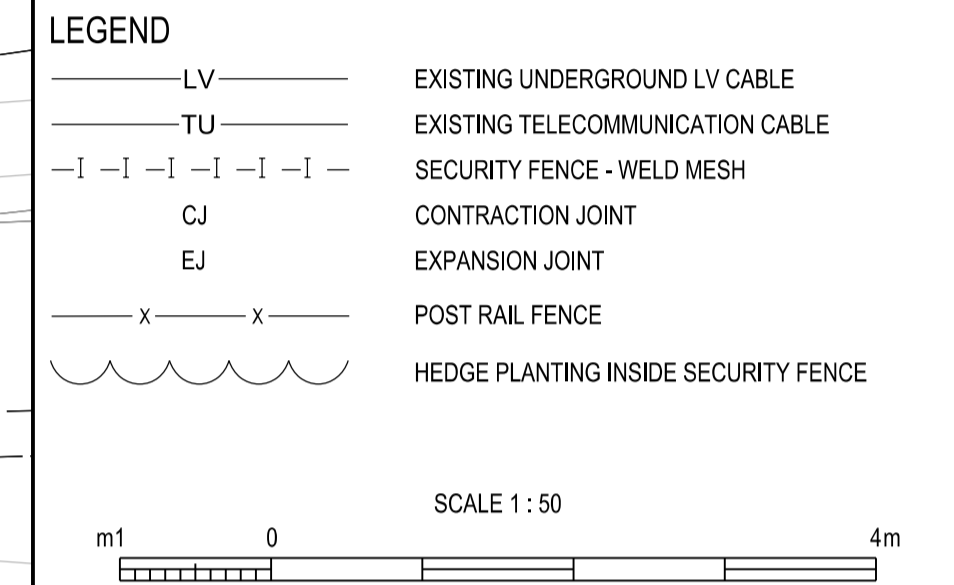

**CURRENT VERSION INFORMATION**

DATE	DRWN	CHKD	REVD	REV	REASON FOR ISSUE
30.11.2017	NC	DRH	YF	C	FOR CONSTRUCTION
19.06.2018	WSA	RPD	DRH	D	FOR CONSTRUCTION
06.11.2018	DLW	YF	RD	E	FOR CONSTRUCTION
29.05.2019	DWH	JAS	SG	F	AS BUILT

THIS DRAWING IS ISSUED BY SOUTHERN WATER SUBJECT TO THE CONDITIONS THAT IT IS NOT COPIED EITHER IN WHOLE OR IN PART OR DISCLOSED TO THIRD PARTIES UNLESS PRIOR WRITTEN AUTHORISATION IS GIVEN BY SOUTHERN WATER. PREVIOUS VERSIONS OF THIS DRAWING SHOULD BE STAMPED SUPERSEDED OR DESTROYED. DO NOT SCALE THIS DRAWING - IF IN DOUBT ASK

*In Partnership with*

Southern House  
Yeoman Road  
Worthing  
West Sussex  
BN13 3NX  
telephone (01903) 264444  
fax (01903) 691435

**PROJECT TITLE**  
MOUNTFIELD - FIRST TIME SEWERAGE SCHEME

**DRAWING TITLE**  
LAYOUT OF INTERMEDIATE PUMPING STATION SHEET 1 OF 3

PRN	SCALE	MASTER SIZE
497392	1:50	A1

